PIPELINE NAME	LATERAL LINE "AS-BUILT"							PIPELINE NAME
R/W NO.	001.00	002.00	003.00	004.00	005.00	006.00	007.00	R/W NO.
OWNERSHIP	59+86.7 OWNER 65' SERVITUDE EASEMENT AND RIGHT OF WAY AGREEMENT 59+37.4	OWNER 65' SERVITUDE EASEMENT AND RIGHT OF WAY AGREEMENT 54+86.6	OWNER 65' SERVITUDE EASEMENT AND RIGHT OF WAY AGREEMENT 40+04.4	OWNER 65' SERVITUDE EASEMENT AND RIGHT OF WAY AGREEMENT 27+75.1	OWNER 65' SERVITUDE EASEMENT AND RIGHT OF WAY AGREEMENT 18+87.7	OWNER 65' SERVITUDE EASEMENT AND RIGHT OF WAY AGREEMENT 14+86.8	OWNER 65' SERVITUDE EASEMENT AND RIGHT OF WAY AGREEMENT 0+00.0	OWNERSHIP
TERRAIN	OPEN	OPEN	OPEN	OPEN	OPEN	OPEN	OPEN	TERRAIN
S-T-R	SURVEY A-							S-T-R
COUNTY, STATE	COUNTY, TEXAS							COUNTY, STATE

STATIONING

@ BALL VALVE
59+86.7 END OF SURVEY

59+71.2 BORE EXIT
59+61.7 FENCE CROSSING
59+59.3 ROW
59+48.3 COUNTY ROAD
59+37.4 PROPERTY LINE
59+29.3 FENCE CROSSING
59+28.1 BURIED CABLE
59+26.8 BORE ENTRY

56+10.1 P.I. ANG.11°50'LT.
55+66.3 P.I. ANG.19°22'LT.

54+96.6 PROPERTY LINE

47+95.2 P.I. ANG.04°55'LT.

44+45.8 P.I. ANG.35°26'RT.

41+49.9 P.I. ANG.18°27'RT.
40+39.2 P.C. SAG
40+24.2 PROPERTY LINE
39+43.3 FENCE CROSSING
39+37.8 P.I. ANG.01°39'RT.
39+29.7 ROW
39+09.8 15° OVER BEND

35+94.4 P.I. ANG.05°33'LT.
35+32.0 P.I. ANG.14°17'LT.
34+88.7 P.I. ANG.12°13'LT.

31+88.5 P.I. ANG.02°10'RT.

30+66.6 ft SAG

29+24.8 P.I. ANG.02°16'RT.
28+32.6 ∠ OVER BEND
28+47.8 ∠ OVER BEND
27+90.4 FENCE CROSSING
27+75.1 PROPERTY LINE
27+59.6 P.I. ANG.55°43'LT.

26+39.7 P.C. SAG

25+37.0 P.I. ANG.41°22'RT.

22+93.4 ∠ OVERBEND

22+50.5 P.I. ANG.34°09'LT.

21+51.6 P.C. SAG

20+61.4 P.I. ANG.05°40'LT.

19+86.4 BORE EXIT
19+36.6 FENCE CROSSING
19+27.5 PROPERTY LINE
19+17.5 EDGE ROAD
18+94.2 EDGE ROAD
18+87.7 PROPERTY LINE
18+34.0 EDGE ROAD
18+26.0 FENCE CROSSING
18+02.0 P.I. ANG.03°33'LT.

15+93.7 P.I. ANG.07°36'LT.
15+49.9 EDGE ROAD
15+49.1 EDGE ROAD
14+88.8 PROPERTY LINE
14+86.8 BORE ENTRY
14+60.5 P.I. ANG.03°21'RT.

13+12.7 P.I. ANG.64°42'RT.

10+85.7 P.C. SAG

8+19.6 P.C. SAG
8+15.0 STREAM

5+88.6 P.I. ANG.64°15'LT.

5+17.2 P.C. SAG

4+60.7 P.I. ANG.04°17'RT.
4+39.6 P.C. SAG

2+75.9 P.C. OVERBEND

2+54.3 P.I. ANG.68°38'RT.

1+69.3 P.I. ANG.45°41'LT.

1+17.6 P.I. ANG.20°57'LT.

0+33.7 P.C. SAG

@ BALL VALVE
0+00.0 BEGIN SURVEY

WELD SCHEMATIC

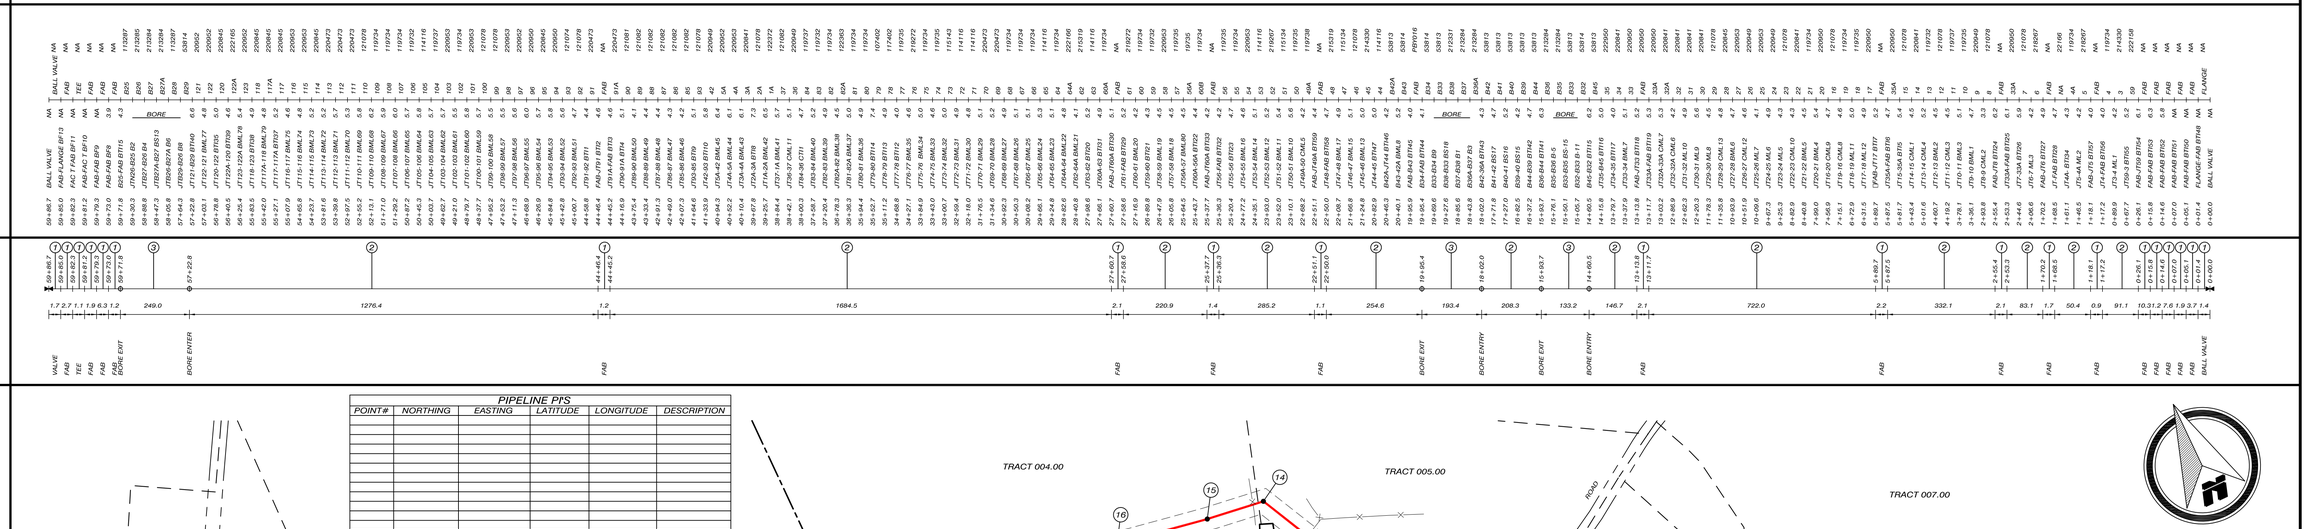

MATERIALS

ALIGNMENT

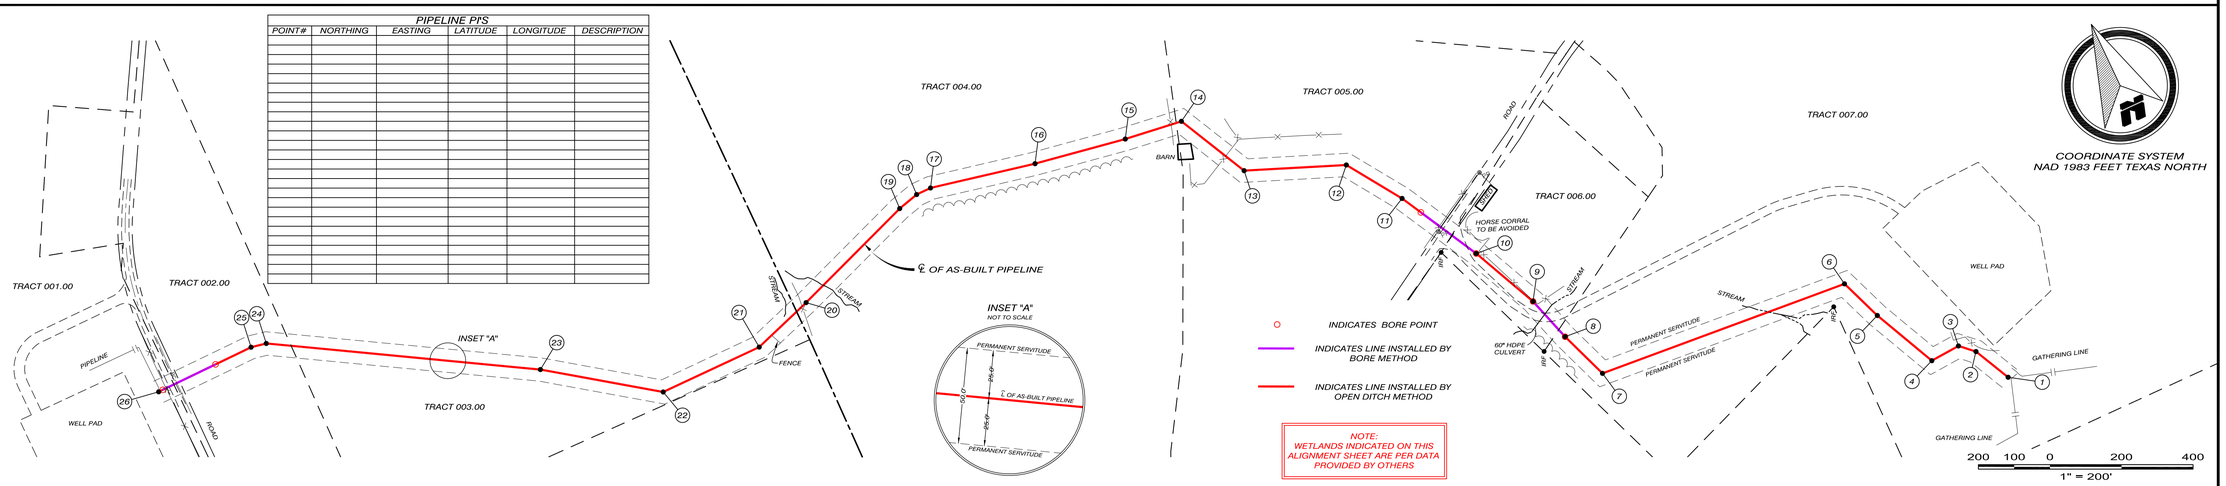

PROFILE

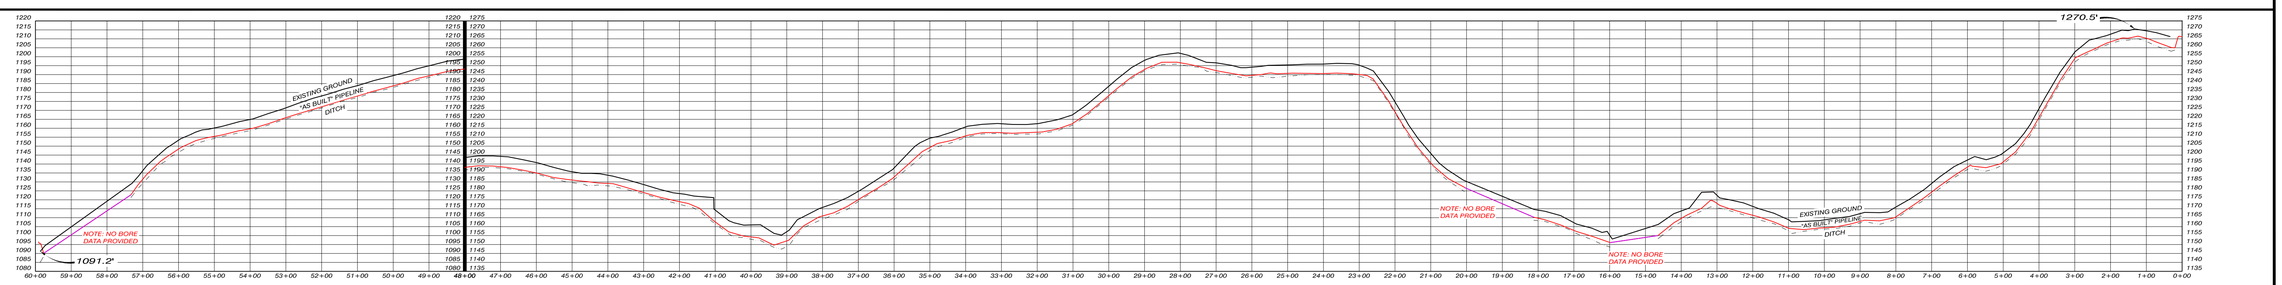

LEGEND

TEST LEAD	U.S. HIGHWAY	FOREIGN PIPELINE	EXISTING MANHOLE
FEDERAL HIGHWAY	COUNTY ROAD	POWER LINE	IRON ROD
STATE HIGHWAY	ROAD SIGN	FENCE	AS-BUILT PIPELINE
EQUATION	TREE	UNDERGROUND CABLE	COUNTY LINE
MILE POST	POWER POLE	WATER LINE	SECTION LINE
WARNING SIGN	WATER METER	TELEPHONE LINE	CITY LIMITS
	VENT PIPE	GAS LINE	RIGHT-OF-WAY LINE
		TREE LINE	RIVER/STREAM
			℄ ROAD
			℄ RR TRACKS

MATERIAL SUMMARY

MK. NO.	QTY.	DESCRIPTION
1	55.8'	8" O.D. X 0.322" W.T. X42/52 FAB
2	5355.3'	8" O.D. X 0.188" W.T. X42/52 FBE
3	575.6'	8" O.D. X 0.250" W.T. X42/52 ARO

REFERENCE DRAWINGS

DWG. NO.	DESCRIPTION

REFERENCE DRAWINGS

DWG. NO.	DESCRIPTION

REVISIONS

NO	DATE	DESCRIPTION
A	12/06/12	ISSUED FOR APPROVAL

RMC SURVEYING
13621 HIGHWAY 110 S
TYLER, TX. 75707
(903) 939-8860
FIRM ID 10122800

DRAWING STATUS

ISSUED FOR	DATE	BY
PRELIM.		
CONST.		
AS-BUILT		

SCALE 1"=200'
DRAWN DWG DATE 12/06/12
CHKD TJC DATE 12/06/12
APPROVED DATE
RMC JOB NO. 12188
AFE NO. 915251
CLIENT FILE NO.
SHEET SHEET 1 OF 1

TITLE
ALIGNMENT SHEET
PROJECT
LATERAL LINE AS-BUILT
COUNTY, TEXAS

NO. JOB NUMBER REV. A